


© Crown copyright and database rights 2021  
Ordnance Survey 100019713.

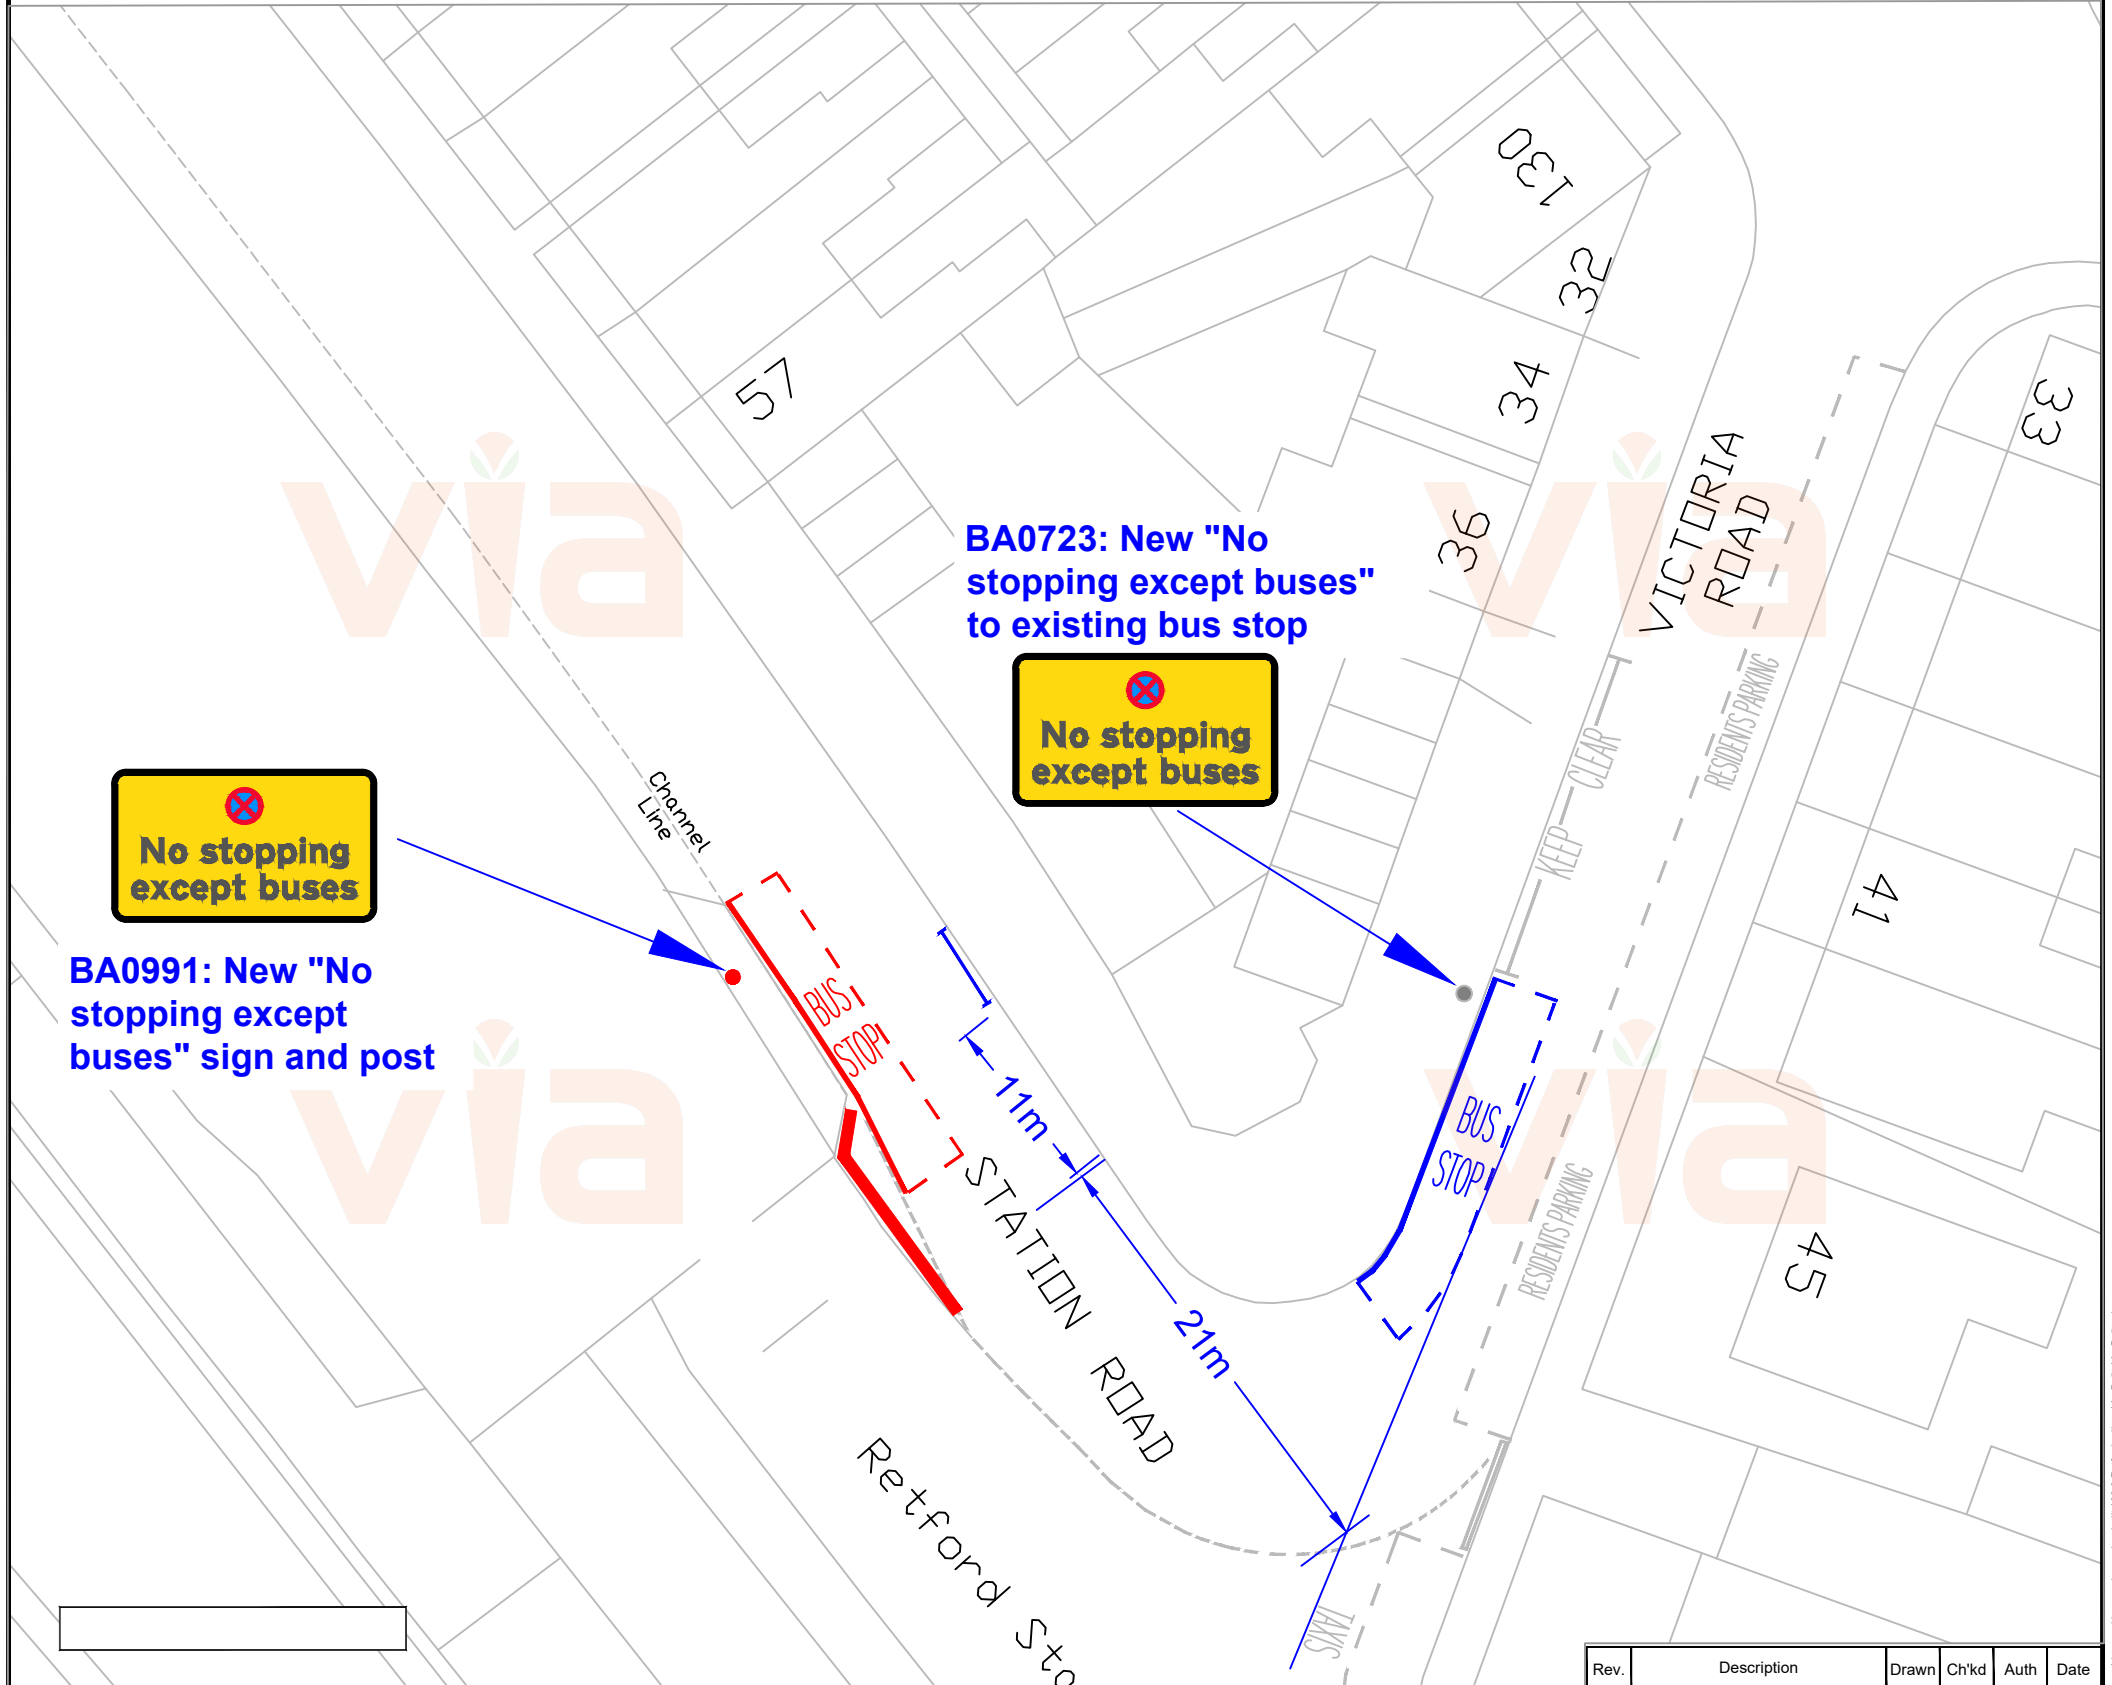


 in partnership with  
  
[www.viaem.co.uk](http://www.viaem.co.uk) Tel 0115 804 2100  
 Bilthorpe Depot, Bilthorpe Business Park, Bilthorpe,  
 Nottinghamshire, NG22 8ST

Project		Retford Railway Station Hotspot Resolution			
Status	Project No.	TP2050439	Drawn	GC	Date
Drawing Title	As Builts - Signs		Ch'kd	JB	Date
Drawing No.	H/GC/3564/17		Auth	HN	Traced
			Rev.	0	Scale
					NTS