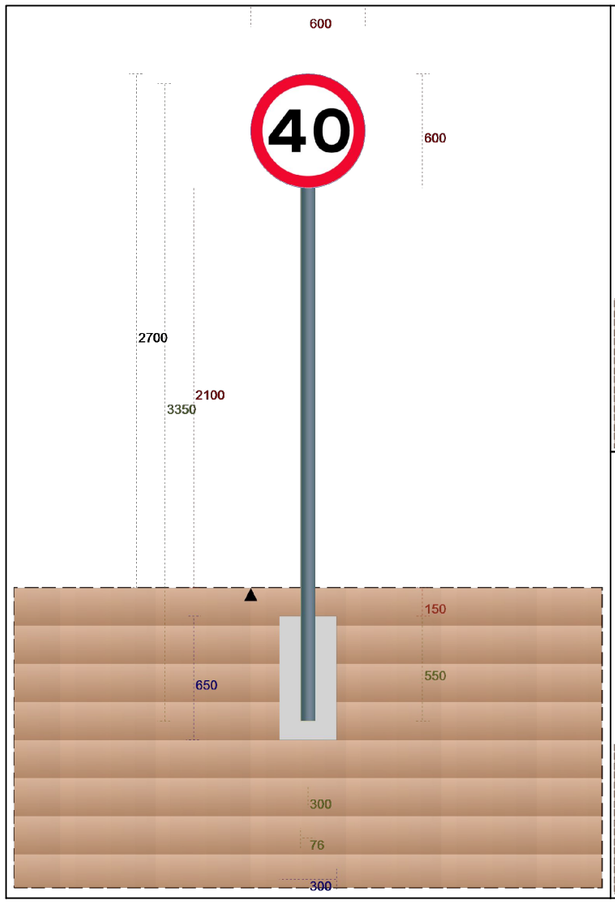

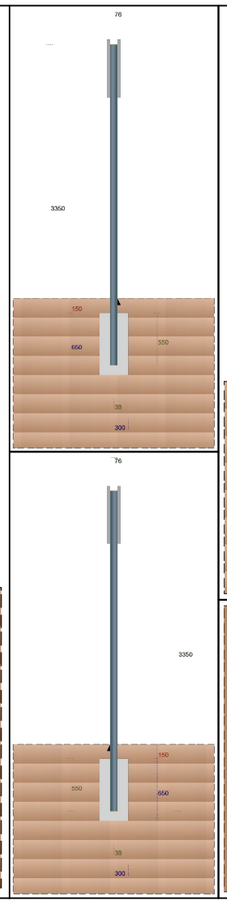

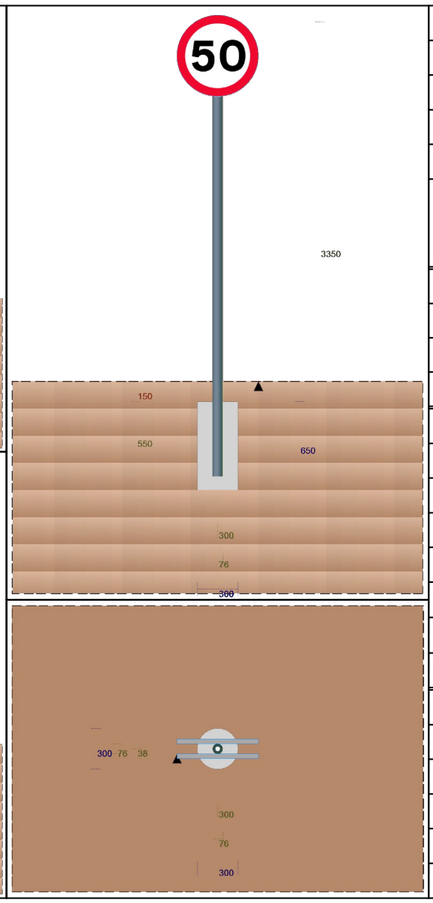

POST(S) & FOUNDATIONS			
Scheme Reference			
Proposal Name	50mph and 40mph terminal		
Proposal Reference			
Author	GC		
Description			
Illumination	No		
Mounting Height	2100mm		
Wind Class	BSEN12899UK	Wind Load	1000 N/m²
Environ Name	England inland	Validated	No
Number	1	Post Shape	Circle
Post Manufacturer	(Unspecified)		
Post Model	Steel Round Post/GenericS275CHS		
Post Type	Steel/S275;S275J2H;A570		
further post info			
Post Size	76.1mm diam x 5.0mm thickness.		
Centres	-		
Length	Total = 3350.0mm, above ground = 2650mm		
No. of Foundations	1		
Foundation Volume	0.046m³		
Foundation Width	300.0mm diameter		
Foundation Length	Circular		
Foundation Depth	650.0mm	Earth Cover	150.0mm
Foundation Material		Reinforcement	

NORTH

Terminal signs

AS BUILT

x 2 Required

Sign Reference	670-40
Height	600 mm
Width	600 mm
Area	0.28 m²
Material	Class RA2 (12899-1:2007)
Mount Height	2100

x 2 Posts

x 8 Required

Sign Reference	670-50
Height	600 mm
Width	600 mm
Area	0.28 m²
Material	Class RA2 (12899-1:2007)
Mount Height	2100

© Crown copyright and database rights 2021 Ordnance Survey 100019713.

Rev.	Description	Drawn	Ch'kd	Auth	Date

Project: A57 Darlton to Dunham - changes to speed limit

Status:

Project No.: TP2050517

Drawing Title: Sign details C

Scale: NTS

Drawn: GC Nov '21

Ch'kd: JB Nov '21

Auth: HN

Traced:

Drawing No.: GC/3511/22

Rev.: 0

in partnership with Nottinghamshire County Council
www.viaem.co.uk Tel 0115 804 2100
Bilsthorpe Depot, Bilsthorpe Business Park, Bilsthorpe, Nottinghamshire, NG22 8ST

© Via East Midlands Limited.Registered in England no.09903246

Nov 15,2021 - 3:11pm C:\Users\gc3\Desktop\to sort 10th Nov\0 to seal has mades and as builts\00 00 02 9 A57 Durham Speed\As Builts and Has Mades\As Builts and Has Mades.dwg