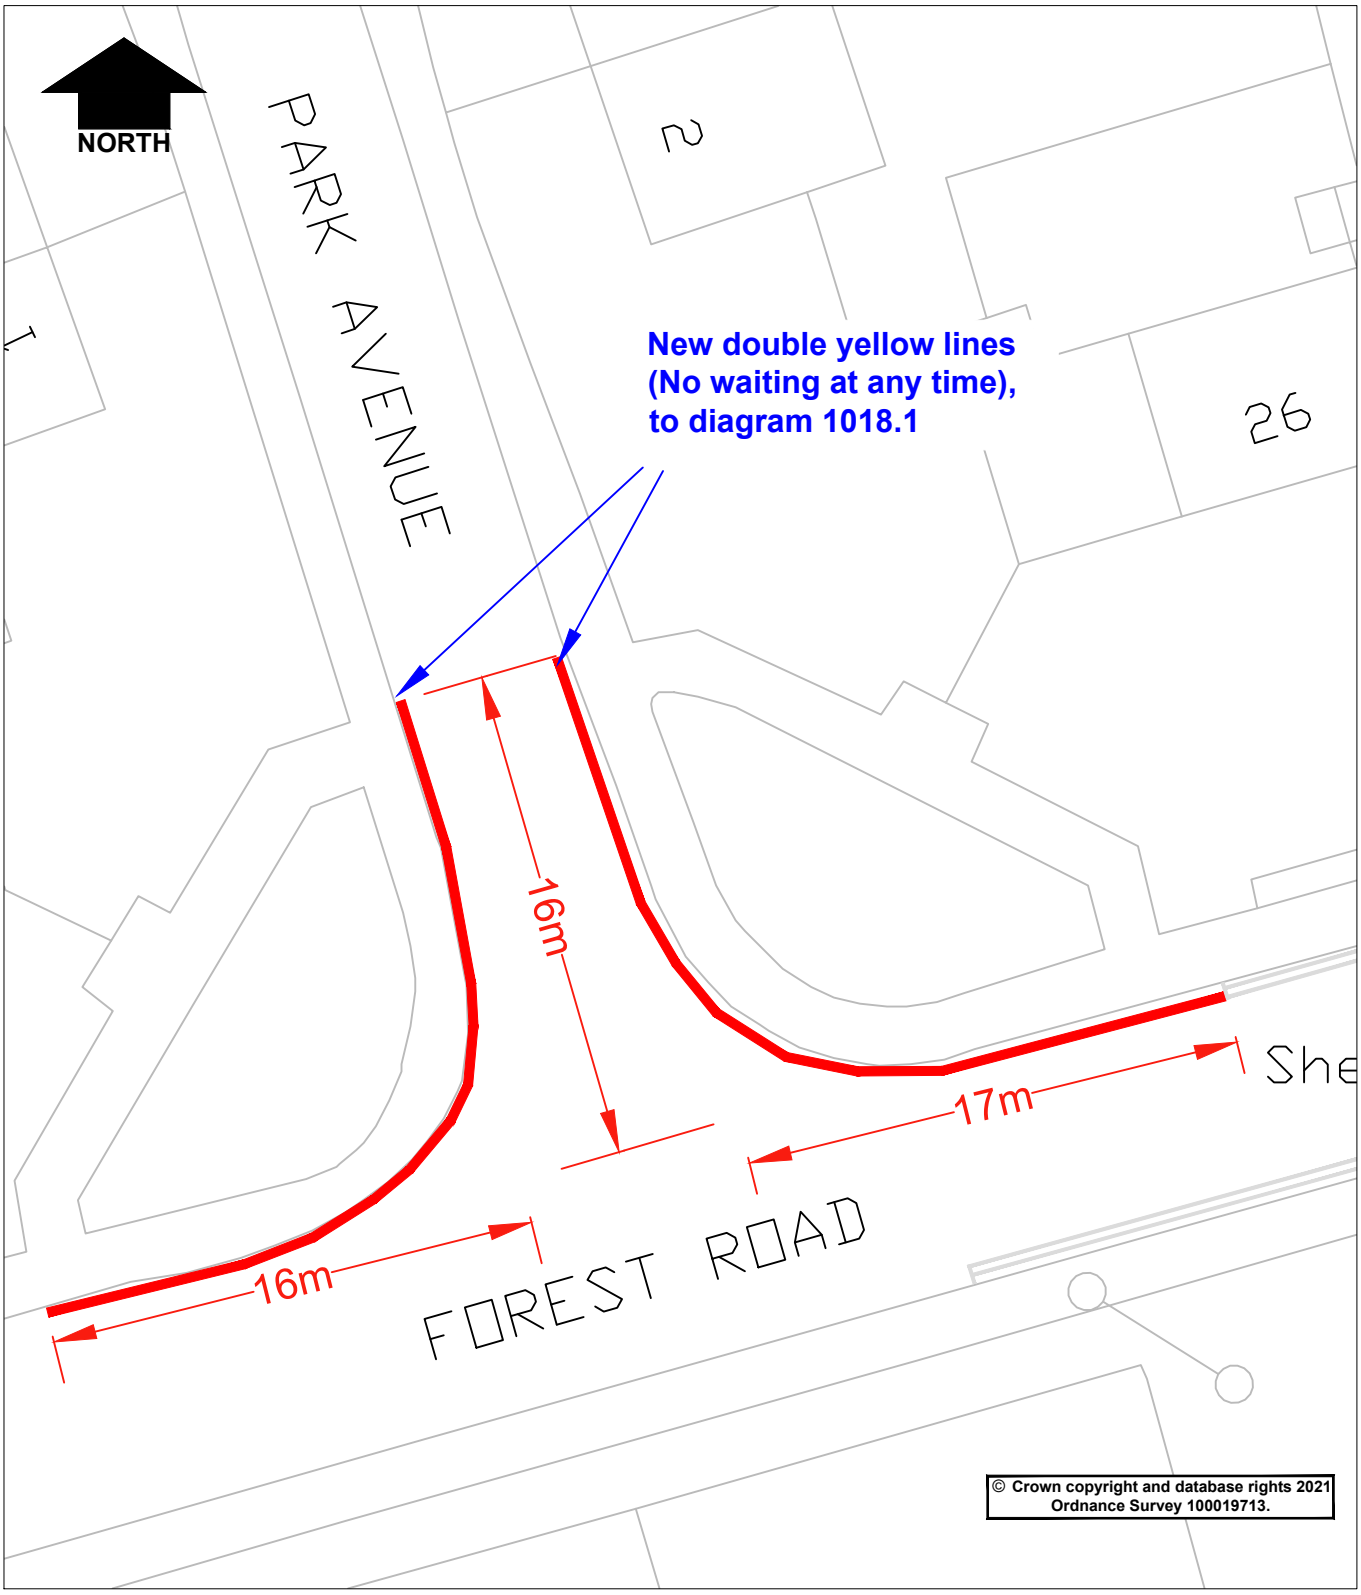

in partnership with Nottinghamshire County Council

www.viaem.co.uk Tel 0115 804 2100
Bilsthorpe Depot, Bilsthorpe Business Park, Bilsthorpe,
Nottinghamshire, NG22 8ST

Project: Forest Road/Park Avenue Kirkby-in-Ashfield		Drawn: GC	Date: June '21
		Ch'kd: JB	Date: June '21
Status: Works	Project No.: CN2050227	Auth: HN	Traced: GC
Drawing Title: New Double Yellow Lines			Scale: NTS
Drawing No.: H/GC/3398/03			Rev.: 0

© Via East Midlands Limited,Registered in England no.09903246

A4

Nov 15,2021 - 2:24pm C:\Users\gjc3\Desktop\to sort 10th Nov\0 to seal has mades and as builts\00 00 01 9 Forest road\As builts and Has Mades.dwg