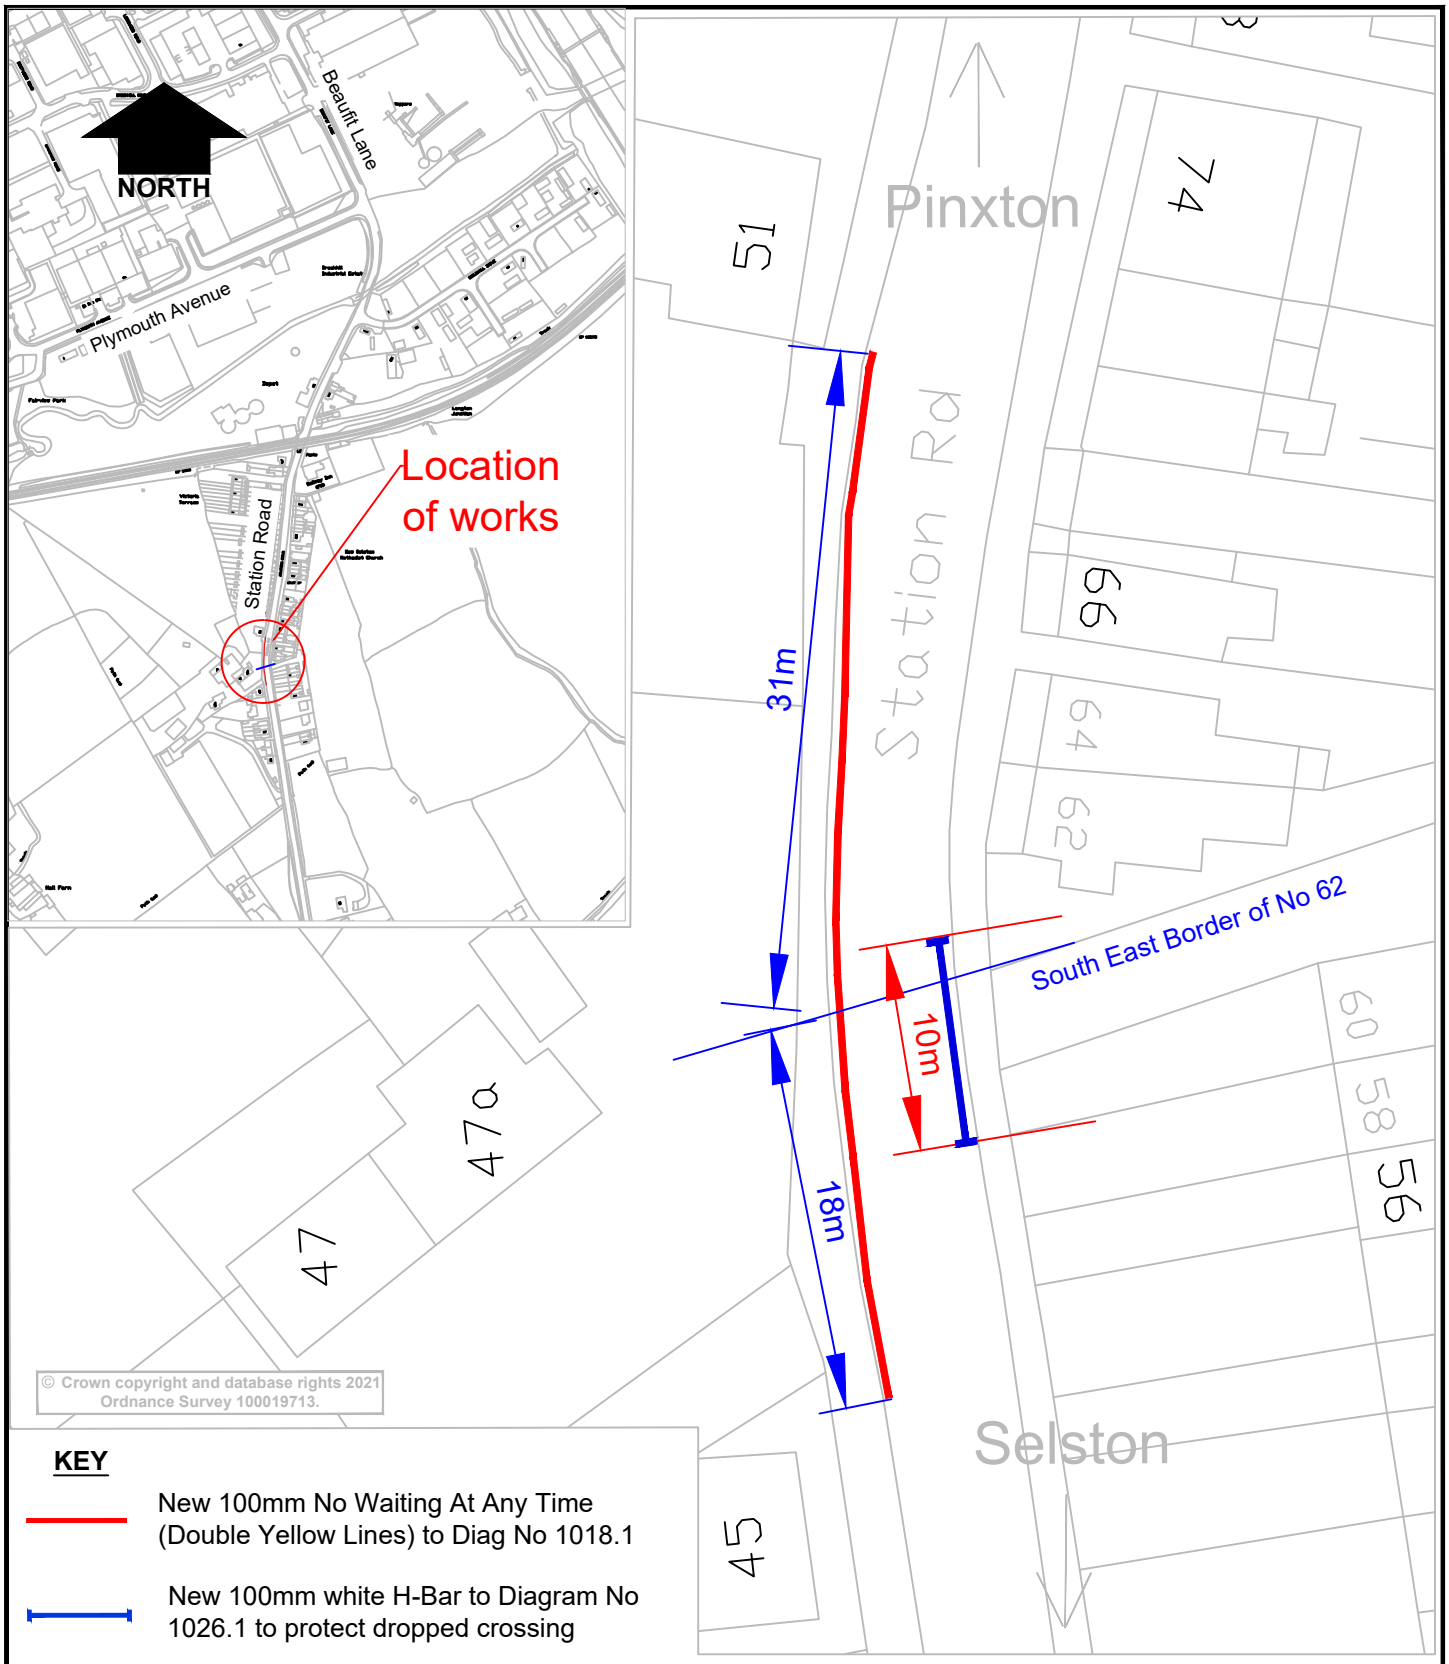

KEY

New 100mm No Waiting At Any Time (Double Yellow Lines) to Diag No 1018.1

New 100mm white H-Bar to Diagram No 1026.1 to protect dropped crossing

in partnership with
Nottinghamshire County Council
www.viaem.co.uk Tel 0115 804 2100
Bilsthorpe Depot, Bilsthorpe Business Park, Bilsthorpe, Nottinghamshire, NG22 8ST

Project: Station Road, Selston		Drawn: GC	Date: July '22
		Ch'kd: JB	Date: July '22
Status: Works	Project No.: TP2150282	Auth: MN	Traced:
Drawing Title: New H-Bar and Double yellow lines			Scale: NTS
Drawing No.: H/GC/3763/04			Rev.: 0

© Via East Midlands Limited,Registered in England no.09903246

A4

Jul 14,2022 - 1:27pm \\ncadmin.ad.nottscc.gov.uk\ncdata\Highways\One Programme\2021-22\TP 2150 282 Station Road Selston [Member request]\B Design Phase\B04 Detailed Design\As builts.dwg