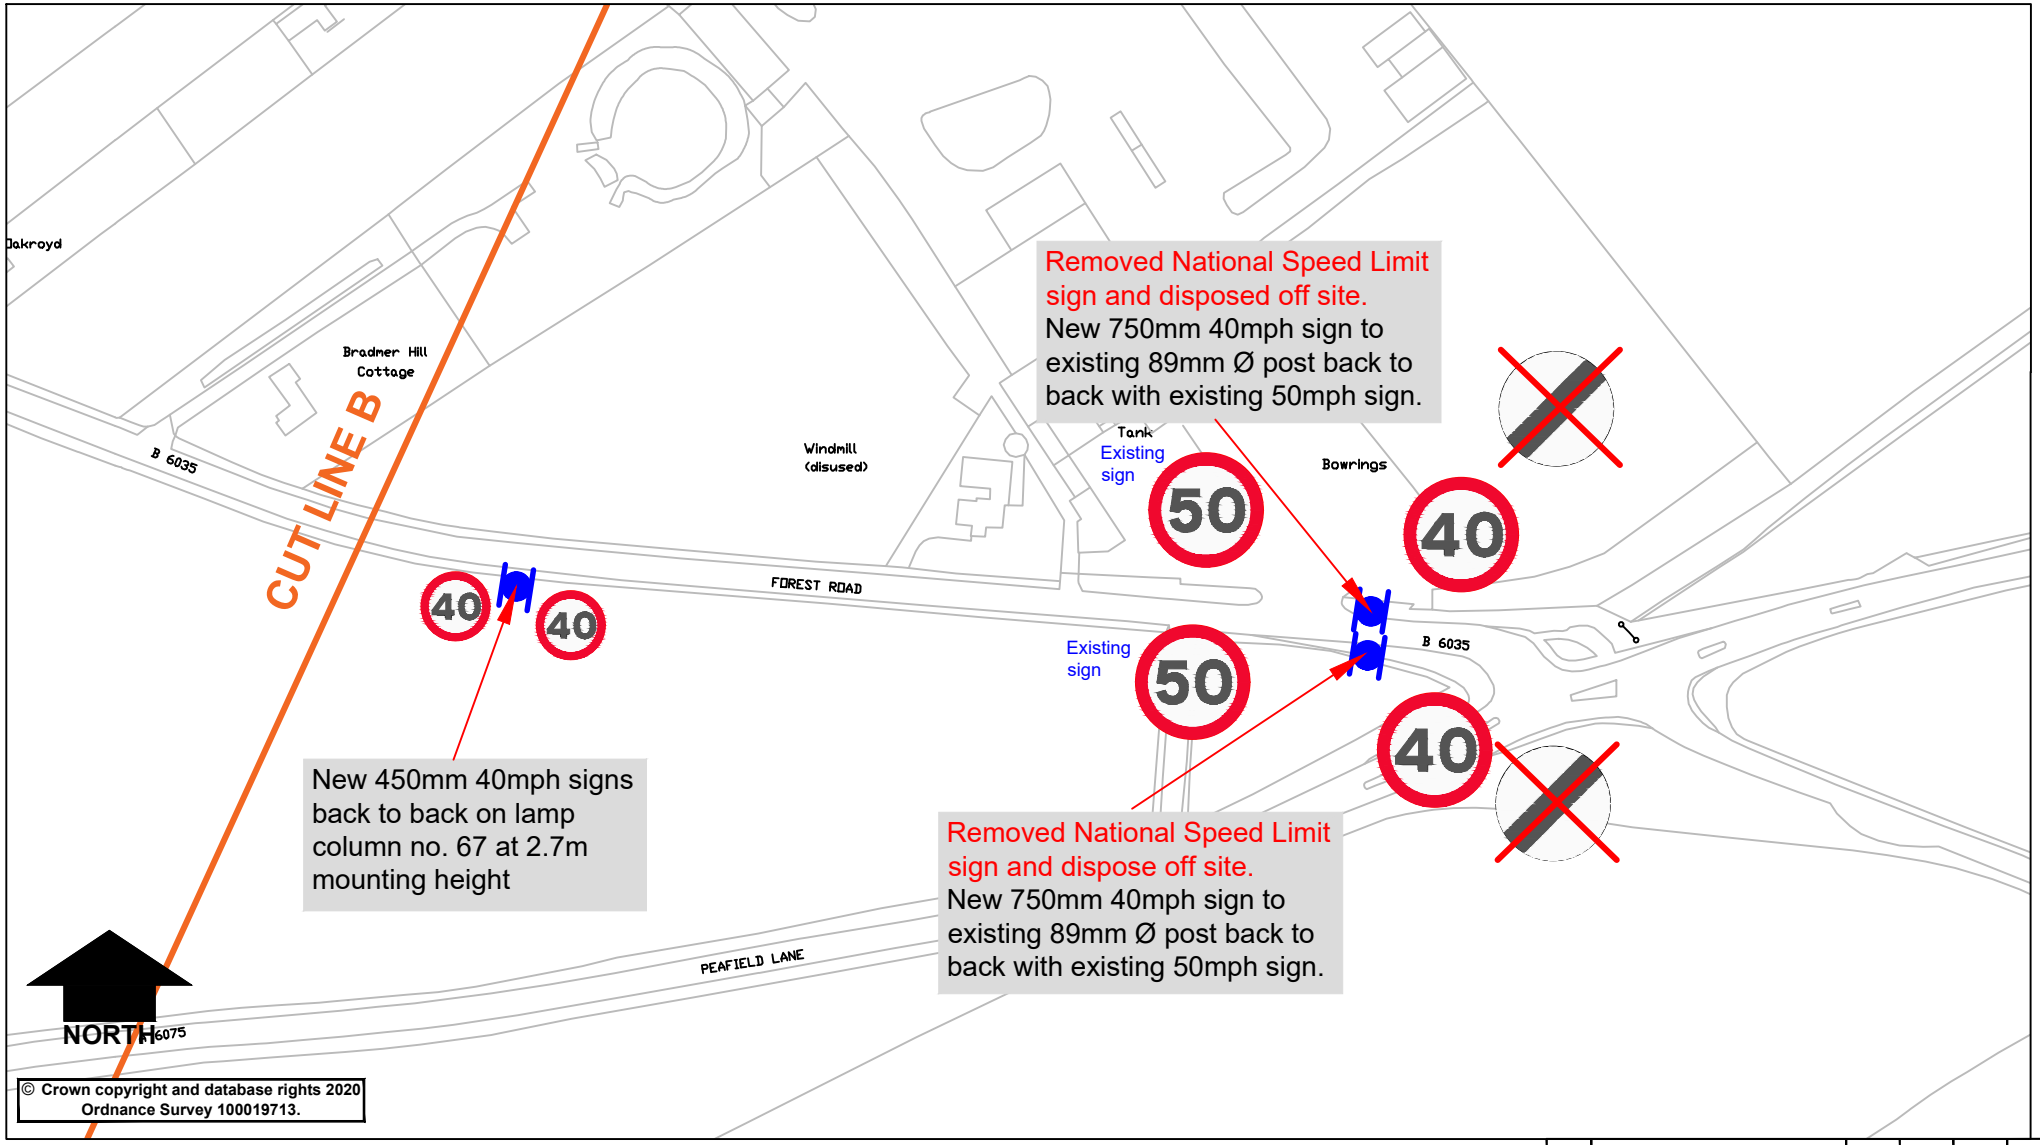

Rev.	Description	Drawn	Ch'kd	Auth	Date

in partnership with Nottinghamshire County Council

www.viaem.co.uk Tel 0115 804 2100
Bilsthorpe Depot, Bilsthorpe Business Park, Bilsthorpe, Nottinghamshire, NG22 8ST

Project: B6035 Forest Rd and B6035 Sherwood St, Market Warsop		Drawn: GC	Date: Nov '21
Status: Has Mades	Project No.: HW 30108 (TRO 2228)	Ch'kd	Date
Drawing Title: 40 M.P.H Speed Limit Order - Has Mades 3 of 3		Auth: HN	Traced
Drawing No.: H/GC/3066/05		Rev.	Scale: 1:2000 @A4

© Via East Midlands Limited,Registered in England no.09903246

A4

Nov 16,2021 - 10:35am C:\Users\gjc3\Desktop\to sort 10th Nov\0 to seal has mades and as builts\00 00 05 9 Forest Road Warsop to seal\As Builts and Has Mades\As Builts and Has Mades.dwg